




REQUEST FOR INFORMATION FORM


SWML-ENG-001
Revision 0
Page 1 of 1

Project No.:	01-26-020 (26766)	RFI No.:	RFI-126020-012
Date:	August 25, 2026	Discipline:	Piping
Project Name:	26766 – BA2107 TLE End-of-Life Replacement		
Subject:	ASC Fig. 40 Riser Clamps – Level Bridle Piping		
Specifications/Documents/Drawings Referenced or Impacted:			
Isometric FA2107-TRIM Rev. 1.1, Sheets 1 and 2, Note 9 ASC Fig. 40 Riser Clamp – Standard, data sheet ASC Fig. 261 Extension Pipe or Riser Clamp, data sheet			
Question or Description of Issue:			
Note 9 of isometric FA2107-TRIM Rev. 1.1, Sheets 1 and 2, specifies ASC Fig. 40 riser clamps on the FA-2107 level bridle piping. Note 9 states: <i>“REMOVE INSULATION AND INSTALL CS ASC RISER CLAMP FIG.40. RISER SHOULD REST ON STEEL. RE-INSULATE PIPING TO MATCH EXISTING.”</i> The 4" Fig. 40 clamps are quoted at \$822.39 each and are not available until early November. ASC originally quoted Fig. 261 clamps, which are available from stock but carry a lower rating: at 4" NPS the Fig. 40 is rated 2,200 lb in a rigid assembly against 750 lb for the Fig. 261. The ASC data sheet for the Fig. 40 also states that load is carried by shear lugs welded to the pipe. Shear lugs are not identified or detailed on the scope drawings, and Note 9 instead indicates that the riser is to rest on steel. Welding shear lugs to the FA-2107 trim piping (4"/2", pipe class 15CS03C, 1950 psig at 650°F, ASME B31.3 normal fluid service) would introduce additional welding, examination and hydrotest requirements beyond those currently shown.			
Originator's Recommended Solution:			
Please review the required support and restraint loads for the level bridle piping and advise whether ASC Fig. 261 clamps are acceptable in lieu of the specified Fig. 40. If the Fig. 261 is not acceptable, please advise whether a field-fabricated support such as angle iron with a tight U-bolt or similar arrangement may be used in order to avoid welding to the existing piping. Please also confirm whether shear lugs are required and, if so, issue the applicable detail together with the associated examination and test requirements.			
Urgency:	Medium (3 days)		
Originator:			
_____ Nitin Joshi Name		_____ Signature	_____ PC Title
		_____ August 25, 2026 Date	

Response:			
Respondent:			
_____ Name	_____ Signature	_____ Title	_____ Date

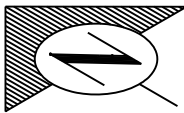

NOTE: PIPING SPOOLS WERE PRE-FABRICATED.
CONTRACTOR TO INSTALL IN FIELD AS SHOWN.

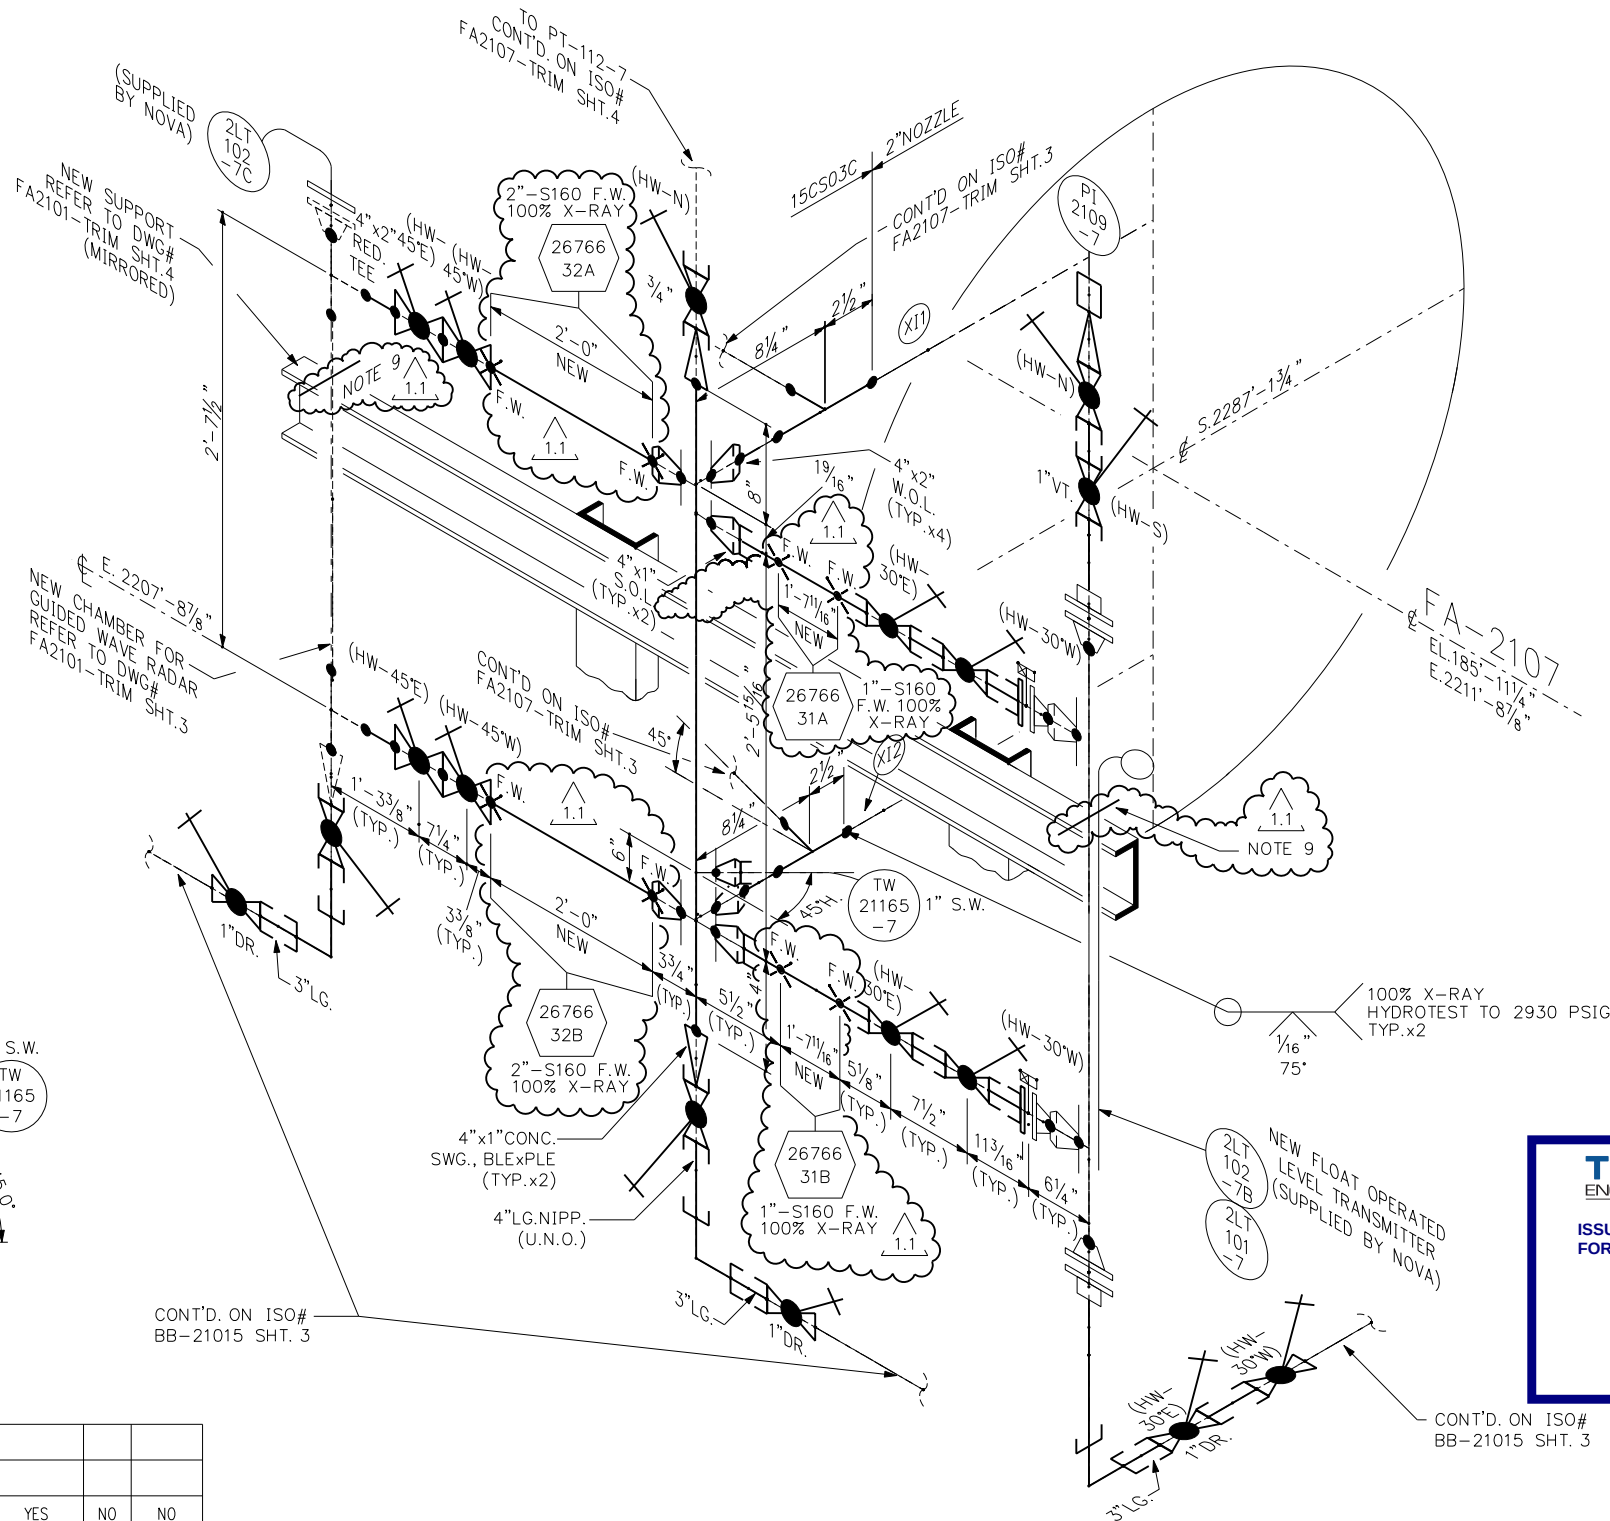

DETAIL #1

15CS03C	1"	TORQUE	TABLE 11	YES	NO	NO
PIPE SPEC	NPS	METHOD ES-PPG-1007	TORQUE TABLE ES-PPG-1004	INSPECTION	UT	RECORD

BOLT TIGHTENING

DES. PRESS.- 1950	PSIG.	DES. TEMP.	650°F. X-RAY 100 %	SIZE	LINE NUMBER	PIPE CLASS
HYDROTEST- NOTE 8	PSIG.	STRESS RELIEF-	☐ YES ☒ NO	4"/2"	FA-2107 TRIM	15CS03C
TRACING	☒ STEAM ☐ ELECTRIC	INSULATION (NOTE 7)	TYPE- 1H (MW) THICK- IN.	1"	FA-2107 TRIM	15CS03C
PAIN	☐ YES ☒ NO	PAIN CODE	N/A	REFERENCE DRAWINGS:	P&ID- D-20006-U	
Proj. No.	23346			PLAN- MODEL		

1.1	MAY 2026	ISSUED FOR CONSTRUCTION - PROJ. # 26766	MG	DG	
1	31/01 2013	APPROVED FOR CONSTRUCTION - CWP-G07 (S/D)	SB		
A	07/01 2013	ISSUED FOR APPROVAL - CWP-G07 (S/D)	SB		
REV.	DATE	DESCRIPTION	DRN.	CHK.	APP.

PIPE							
REV.	ITEM	QUANTITY	NOMINAL DIAMETER	ENG. CODE	SAP CODE	DESCRIPTION	
*	1	5'	4"	PIOICST2BWOI		PIPE BE SI20 SMLS ASTM A106 GR. B	
*	2	3'	2"	PIOICST4BWOI		PIPE SI60 SMLS BE ASTM A106 GR. B	
*	3	2'	1"	PIOICST4SWOI		PIPE SI60 SMLS PE ASTM A106 GR. B	
FITTINGS							
REV.	ITEM	QUANTITY	MAIN SIZE	RED SIZE	ENG. CODE	SAP CODE	DESCRIPTION
	4	3	1"	N/A	EB04CS60SW02		ELBOW 90 6000# SW ASTM A105N
	5	2	1"	N/A	FL43CS15RF02		FLG SW SI60 BORE I500# RF ASTM A105N
	6	3	1"	N/A	NI03CS74PPOI		NIPPLE 3" LG SI60 PBE SMLS ASTM A106 GR B
	7	10	1"	N/A	NI04CS74PPOI		NIPPLE 4" LG SI60 PBE SMLS ASTM A106 GR B
	8	3	4"	1"	OL03CS60SW02		SOCKOLET 6000# ASTM A105N
	9	4	4"	2"	OL05CS74BW02		WELDOLET SI60 ASTM A105N
	10	4	1"	N/A	PL04CS60TD02		PLUG 6000# THRD ROUND HEAD ASTM A105N
*	11	1	4"	1"	SC72CS72BP0I		SWAGE NIP. CON. SI20 BLE/SI60 PSE ASTM A234 GR. WPB
*	12	1	4"	3/4"	SC72CS72BP0I		SWAGE NIP. CON. SI20 BLE/SI60 PSE ASTM A234 GR. WPB
*	13	1	1"	1/2"			SWAGE CON SI60 TBE ASTM A234 GR. WPB
*	14	1	1/2"	1/2"			CPLG FULL 6000# THRD ASTM A105N
	15	2	2"	2"	TEOICST4BWOI		TEE STRAIGHT SI60 BW ASTM A234 GR. WPB
VALVES							
REV.	ITEM	QUANTITY	MAIN SIZE	RED SIZE	ENG. CODE	SAP CODE	DESCRIPTION
*	16	4	2"	N/A			GLOBE, Y-PATTERN, I500# BW, CONVAL# I2G4QZ-I05 (8J)
*	17	8	1"	N/A			GLOBE, Y-PATTERN I500# SW, CONVAL# I2G2QZ-I05 (5F)
*	18	4	1"	N/A			GLOBE, Y-PATTERN I500# SWxTHRD, CONVAL# I2G0QZ-I05 (5F)
*	19	1	3/4"	N/A			GLOBE, Y-PATTERN I500# SW, CONVAL# I2G2QZ-I05 (5F)
BOLTS							
REV.	ITEM	QUANTITY	BOLT DIA.	LENGTH	ENG. CODE	SAP CODE	DESCRIPTION
*	20	8	0.875	5.0	BT0I193B700		STUD BOLT A193 B7 c/w 2 HWY HEX NUTS A194 2H
GASKETS							
REV.	ITEM	QUANTITY	MAIN SIZE	ENG. CODE	SAP CODE	DESCRIPTION	
	21	2	1"	GKC46I5RF03		I500# 304 SPIRAL WND CS IN/OUT RINGS FLEX GRAPHITE FILLED	
GAUGE AND BLEED VALVES							
REV.	ITEM	QUANTITY	MAIN SIZE	ENG. CODE	SAP CODE	DESCRIPTION	
*	22	1	3/4"	IG60CSECOIF	-	GAUGE VALVE, TYPE P-2, HEX MODEL # HG473S423U23	
*	23	1	1/2"	IG60CSDOIS	-	BLEED VALVE, TYPE-P2, HEX MODEL # HB-25IS312	

PIPE					
REV. ITEM	QUANTITY	NOMINAL DIAMETER	COMMODITY CODE	MD NUMBER	DESCRIPTION
1	4'	1"	PNNPAAAAPECRAA16	I502957	PIPE, ASME B36.10M, SMLS, PE, ASTM A106 GR. B, SCH. 160
2	4'	2"	PNNPAAAABECRAA16	I079677	PIPE, ASME B36.10M, SMLS, BE, ASTM A106 GR. B, SCH. 160

BILL OF MATERIAL PER NOVA PIPE SPECIFICATION 15CS03C, REVISION 9

NOTES:

- FIELD CHECK ALL DIMENSIONS PRIOR TO PIPE FABRICATION.
- VENT, DRAIN & PI CONNECTIONS SHALL BE GUSSETED AS PER STANDARD DETAIL DRAWING No. ES-PPG-8117.
- * INDICATES ITEMS IN THE BILL OF MATERIAL THAT HAVE BEEN MANUALLY MODIFIED FROM THE BITWYSE DATABASE.
- NOVA INSPECTION SHALL VERIFY THE INTEGRITY OF ALL EXISTING, RE-USED PIPING PRIOR TO MAKING ANY TIE-INS.
- PIPING SHALL BE EXAMINED PRIOR TO HYDROTEST AS INDICATED FOR ASME B31.3 FLUID CATEGORY.
- VISUAL WELD INSPECTION
 - ☒ NORMAL FLUID SERVICE
5% OF FABRICATION FOR EACH WELDER SHALL BE EXAMINED AS OUTLINED IN TABLE 341.3.2.
 - ☐ CATEGORY D FLUID SERVICE
VISUAL EXAMINATION TO EXTENT NECESSARY TO SATISFY EXAMINER.
- FOR 2" NPS OR LESS, USE 2" THICK INSULATION & FOR 3" NPS OR GREATER, USE 2.5" THICK INSULATION.
- SHOP HYDROTEST NEW FLOAT OPERATED LEVEL TRANSMITTER TO 3445 PSIG & ALL OTHER PIPING TO 4050 PSIG. FIELD HYDROTEST ALL PIPING TO 2930 PSIG.
- REMOVE INSULATION AND INSTALL CS ASC RISER CLAMP FIG.40. RISER SHOULD REST ON STEEL. RE-INSULATE PIPING TO MATCH EXISTING.






BA-2107
HEATER #7



DWG. NO. FA2107-TRIM

SHT. 10F

REV. 1.1

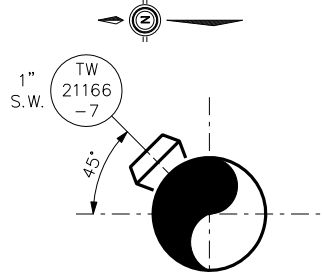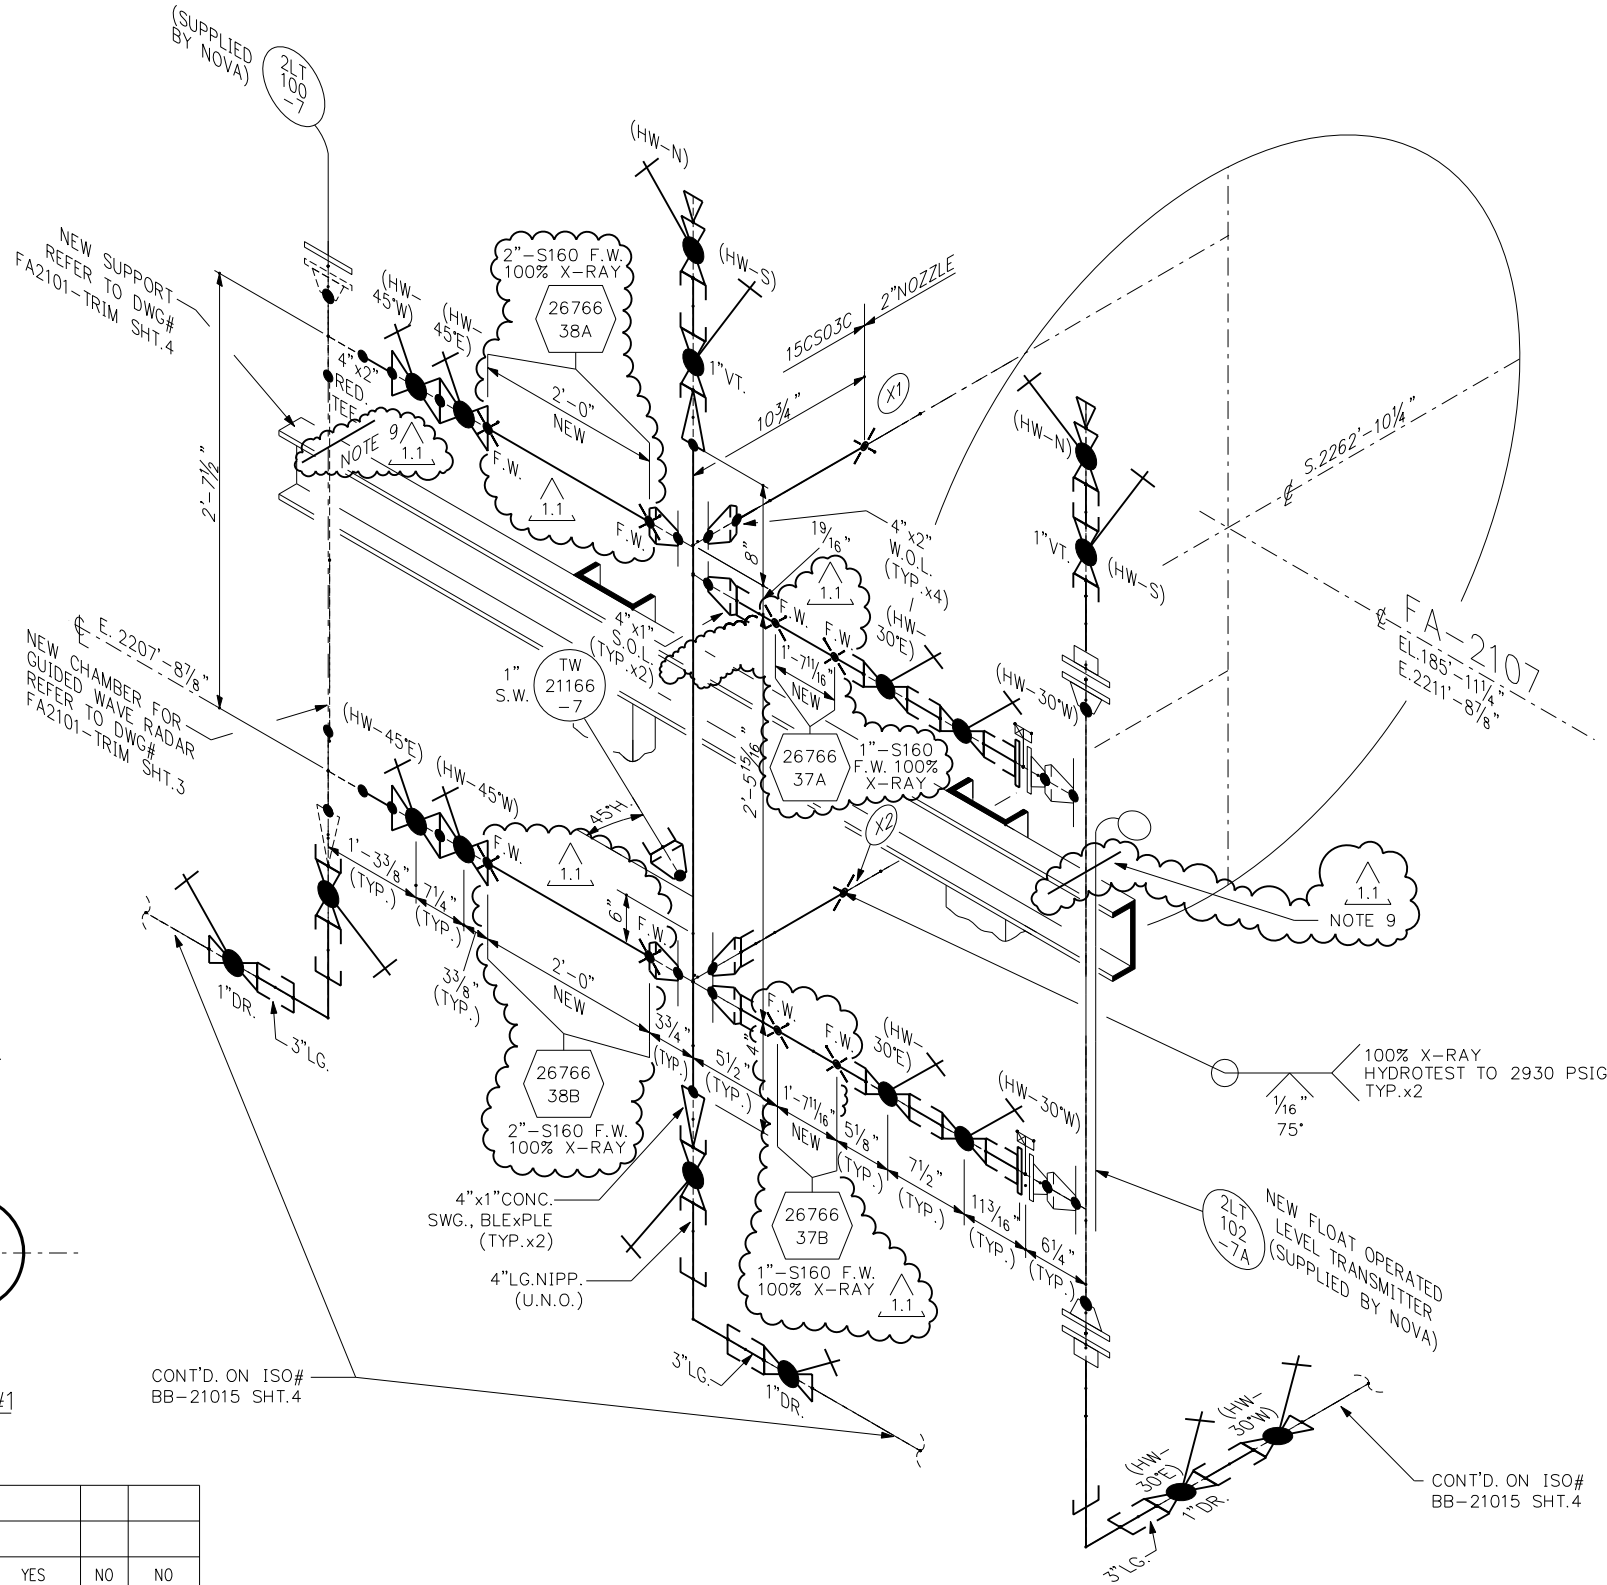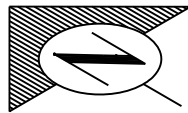

15CS03C	1"	TORQUE	TABLE 11	YES	NO	NO
PIPE SPEC	NPS	METHOD ES-PPG-1007	TORQUE TABLE ES-PPG-1004	INSPECTION	UT	RECORD

BOLT TIGHTENING

DES. PRESS.- 1950	PSIG.	DES. TEMP.	650°F. X-RAY 100 %	SIZE	LINE NUMBER	PIPE CLASS
HYDROTEST- NOTE 8	PSIG.	STRESS RELIEF-	☐ YES ☒ NO	4"/2"	FA-2107 TRIM	15CS03C
TRACING	☒ STEAM ☐ ELECTRIC	INSULATION (NOTE 7)	TYPE- 1H (MW) THICK- IN.	1"	FA-2107 TRIM	15CS03C
PAIN	☐ YES ☒ NO	PAIN CODE	N/A	P&ID- D-20006-U	PLAN- MODEL	
Proj. No.	23346					

1.1	MAY 2026	ISSUED FOR CONSTRUCTION - PROJ. # 26766
1	31/01 2013	APPROVED FOR CONSTRUCTION - CWP-G07 (S/D)
A	07/01 2013	ISSUED FOR APPROVAL - CWP-G07 (S/D)
REV.	DATE	DESCRIPTION



BA-2107
HEATER #7



DWG. NO. FA2107-TRIM

SHT. 2 OF

REV. 1.1

PIPE				ENG. CODE	SAP CODE	DESCRIPTION
REV. ITEM	QUANTITY	NOMINAL DIAMETER				
1	5'	4"		PIOICS72BW0I		PIPE BE SI20 SMLS ASTM A106 GR. B
2	4'	2"		PIOICS74BW0I		PIPE SI60 SMLS BE ASTM A106 GR. B
3	2'	1"		PIOICS74SW0I		PIPE SI60 SMLS PE ASTM A106 GR. B
FITTINGS						
REV. ITEM	QUANTITY	MAIN SIZE	RED. SIZE	ENG. CODE	SAP CODE	DESCRIPTION
4	3	1"	N/A	EB04CS60SW02		ELBOW 90 6000# SW ASTM A105N
5	2	1"	N/A	FL43CS15RF02		FLG SW SI60 BORE 1500# RF ASTM A105N
6	3	1"	N/A	NI03CS74RPOI		NIPPLE 3' LG SI60 PBE SMLS ASTM A106 GR B
7	11	1"	N/A	NI04CS74PPOI		NIPPLE 4' LG SI60 PBE SMLS ASTM A106 GR B
8	3	4"	1"	OL03CS60SW02		SOCKOLET 6000# ASTM A105N
9	4	4"	2"	OL05CS74BW02		WELDOLET SI60 ASTM A105N
10	5	1"	N/A	PL04CS60TD02		PLUG 6000# THRD ROUND HEAD ASTM A105N
11	2	4"	1"	SC72CS72BP0I		SWAGE NIP. CON. SI20 BLE/SI60 PSE ASTM A234 GR. WPB
VALVES						
REV. ITEM	QUANTITY	MAIN SIZE	RED. SIZE	ENG. CODE	SAP CODE	DESCRIPTION
12	4	2"	N/A			GLOBE, Y-PATTERN 1500# BW, CONVAL# I2G4QZ-I05 (8J)
13	9	1"	N/A			GLOBE, Y-PATTERN 1500# SW, CONVAL# I2G2OZ-I05 (5F)
14	5	1"	N/A			GLOBE, Y-PATTERN 1500# SW, THRD, CONVAL# I2G0OZ-I05 (5F)
BOLTS						
REV. ITEM	QUANTITY	BOLT DIA.	LENGTH	ENG. CODE	SAP CODE	DESCRIPTION
15	8	0.875	5.0	BT01H93B700		STUD BOLT A193 B7 c/w 2 HVY HEX NUTS A194 2H
GASKETS						
REV. ITEM	QUANTITY	MAIN SIZE		ENG. CODE	SAP CODE	DESCRIPTION
16	2	1"		GKC4615RF03		1500# 304 SPIRAL WND CS IN/OUT RINGS FLEX GRAPHITE FILLED


PIPE						
REV. ITEM	QUANTITY	NOMINAL DIAMETER	COMMODITY CODE	MD NUMBER	DESCRIPTION	
1	4'	1"	PNNPAAAAPECRAA16	1502957	PIPE, ASME B36.10M, SMLS, PE, ASTM A106 GR. B, SCH. 160	
2	4'	2"	PNNPAAAAPECRAA16	1079677	PIPE, ASME B36.10M, SMLS, BE, ASTM A106 GR. B, SCH. 160	

1.1

BILL OF MATERIAL PER NOVA PIPE SPECIFICATION 15CS03C, REVISION 9

NOTES:

1. FIELD CHECK ALL DIMENSIONS PRIOR TO PIPE FABRICATION.
2. VENT, DRAIN & PI CONNECTIONS SHALL BE GUSSETED AS PER STANDARD DETAIL DRAWING No. ES-PPG-8117.
3. * INDICATES ITEMS IN THE BILL OF MATERIAL THAT HAVE BEEN MANUALLY MODIFIED FROM THE BITWYSE DATABASE.
4. NOVA INSPECTION SHALL VERIFY THE INTEGRITY OF ALL EXISTING, RE-USED PIPING PRIOR TO MAKING ANY TIE-INS.
5. PIPING SHALL BE EXAMINED PRIOR TO HYDROTEST AS INDICATED FOR ASME B31.3 FLUID CATEGORY.
6. VISUAL WELD INSPECTION
 - ☒ NORMAL FLUID SERVICE
5% OF FABRICATION FOR EACH WELDER SHALL BE EXAMINED AS OUTLINED IN TABLE 341.3.2.
 - ☐ CATEGORY D FLUID SERVICE
VISUAL EXAMINATION TO EXTENT NECESSARY TO SATISFY EXAMINER.
7. FOR 2" NPS OR LESS, USE 2" THICK INSULATION & FOR 3" NPS OR GREATER, USE 2.5" THICK INSULATION.
8. SHOP HYDROTEST NEW FLOAT OPERATED LEVEL TRANSMITTER TO 3445 PSIG & ALL OTHER PIPING TO 4050 PSIG. FIELD HYDROTEST ALL PIPING TO 2930 PSIG.
9. REMOVE INSULATION AND INSTALL CS ASC RISER CLAMP FIG.40. RISER SHOULD REST ON STEEL. RE-INSULATE PIPING TO MATCH EXISTING.

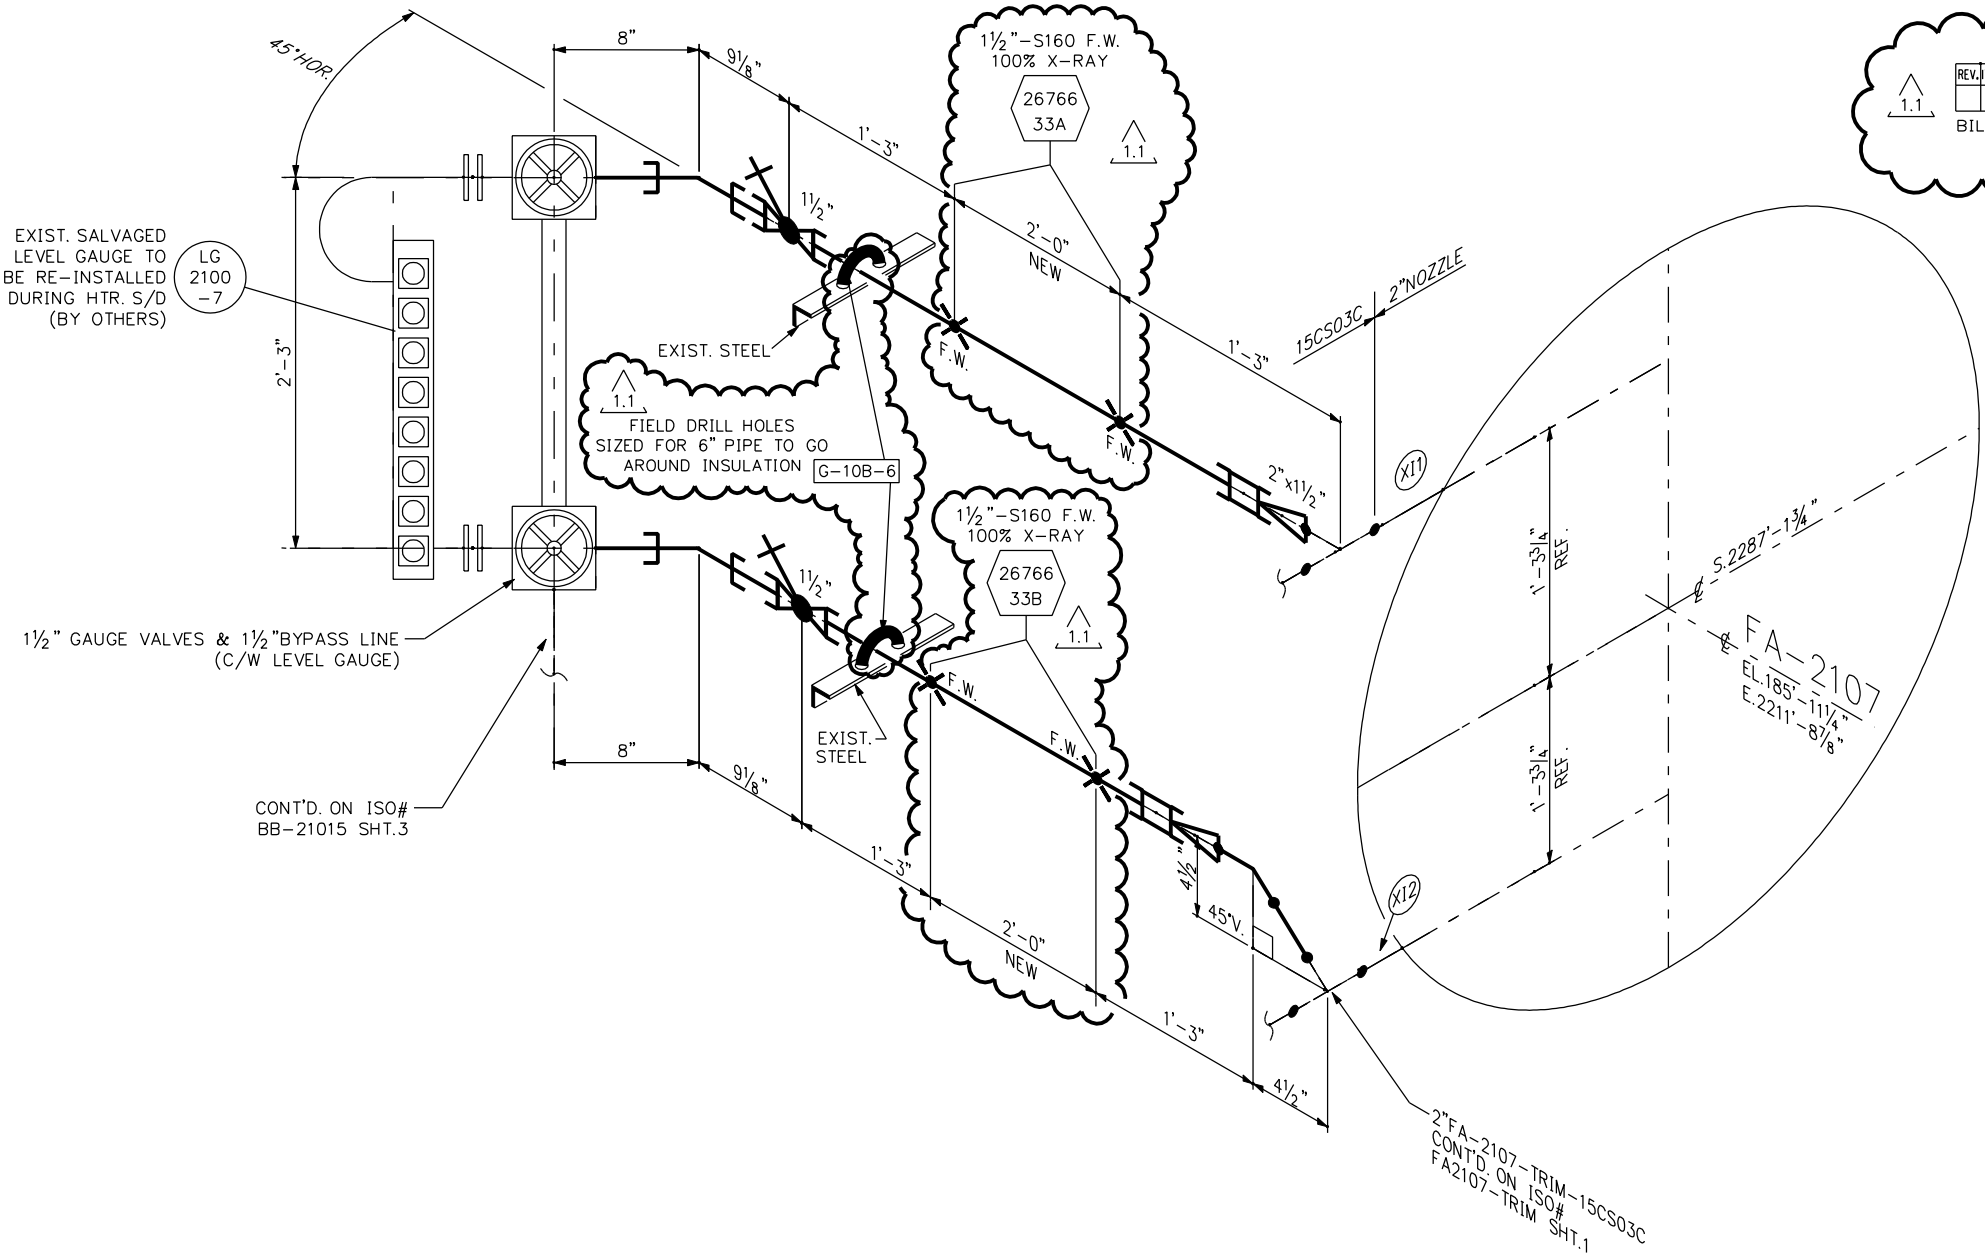

PIPE						
REV.	ITEM	QUANTITY	NOMINAL DIAMETER	ENG. CODE	SAP CODE	DESCRIPTION
*	1	6	1 1/2"	PIOICS74SWOI		PIPE S160 SMLS PE ASTM A106 GR. B
	2	1'	2"	PIOICS74BWOI		PIPE S160 SMLS BE ASTM A106 GR. B
FITTINGS						
REV.	ITEM	QUANTITY	MAIN SIZE	RED SIZE	ENG. CODE	SAP CODE
	3	2	1 1/2"	1 1/2"	CPOICS60SWOI	
	4	2	1 1/2"	N/A	EBOICS60SWO2	
	5	1	2"	N/A	EB02CS74BWOI	
	6	2	2"	1 1/2"	SC74CS74BP01	
VALVES						
REV.	ITEM	QUANTITY	MAIN SIZE	RED SIZE	ENG. CODE	SAP CODE
*	7	2	1 1/2"	N/A		

PIPE						
REV.	ITEM	QUANTITY	NOMINAL DIAMETER	COMMODITY CODE	MID NUMBER	DESCRIPTION
	1	4'	1 1/2"	PNNPAAAAPECRAAIG	I504466	PIPE, ASME B36.10M, SMLS, PE, ASTM A106 GR. B, SCH. 160
BILL OF MATERIAL PER NOVA PIPE SPECIFICATION 15CS03C, REVISION 9						

TECSAR
ENGINEERING INC.

ISSUED / APPROVED
FOR CONSTRUCTION

06/04/2026

- NOTES:
1. FIELD CHECK ALL DIMENSIONS PRIOR TO PIPE FABRICATION.
 2. VENT, DRAIN & PI CONNECTIONS SHALL BE GUSSETED AS PER STANDARD DETAIL DRAWING No. ES-PPG-8117.
 3. * INDICATES ITEMS IN THE BILL OF MATERIAL THAT HAVE BEEN MANUALLY MODIFIED FROM THE BITWYSE DATABASE.
 4. NOVA INSPECTION SHALL VERIFY THE INTEGRITY OF ALL EXISTING, RE-USED PIPING PRIOR TO MAKING ANY TIE-INS.
 5. PIPING SHALL BE EXAMINED PRIOR TO HYDROTEST AS INDICATED FOR ASME B31.3 FLUID CATEGORY.
 6. VISUAL WELD INSPECTION
 - ☒ NORMAL FLUID SERVICE
5% OF FABRICATION FOR EACH WELDER SHALL BE EXAMINED AS OUTLINED IN TABLE 341.3.2.
 - ☐ CATEGORY D FLUID SERVICE
VISUAL EXAMINATION TO EXTENT NECESSARY TO SATISFY EXAMINER.
 7. SHOP HYDROTEST NEW FLOAT OPERATED LEVEL TRANSMITTER TO 3445 PSIG & ALL OTHER PIPING TO 4050 PSIG. FIELD HYDROTEST ALL PIPING TO 2930 PSIG.



BA-2107
HEATER #7

DES. PRESS.- 1950 PSIG.	DES. TEMP. 650°F. X-RAY 100 %	SIZE	LINE NUMBER	PIPE CLASS	1.1	MAY 2026	ISSUED FOR CONSTRUCTION - PROJ. # 26766	MG	DG	
HYDROTEST- NOTE 8 PSIG.	STRESS RELIEF- ☐ YES ☒ NO	1 1/2" / 1"	FA-2107 TRIM	15CS03C	1	31/01 2013	APPROVED FOR CONSTRUCTION - CWP-G07 (S/D)	SB	JG	CB
TRACING	☒ STEAM ☐ ELECTRIC	INSULATION	TYPE- 1H (MW) THICK- 2 IN.	REFERENCE DRAWINGS:	A	07/01 2013	ISSUED FOR APPROVAL - CWP-G07 (S/D)	SB	JG	CB
PAIN	☐ YES ☒ NO	PAINT CODE	N/A	P&ID- D-20006-U PLAN- MODEL	REV.	DATE	DESCRIPTION	DRN.	CHK.	APP.
Proj. No.	23346									




DWG. NO. FA2107-TRIM

SHT. 30F

REV. 1.1

Extension Pipe or Riser Clamp

Fig. 261 (Formerly Afcon Fig. 400)

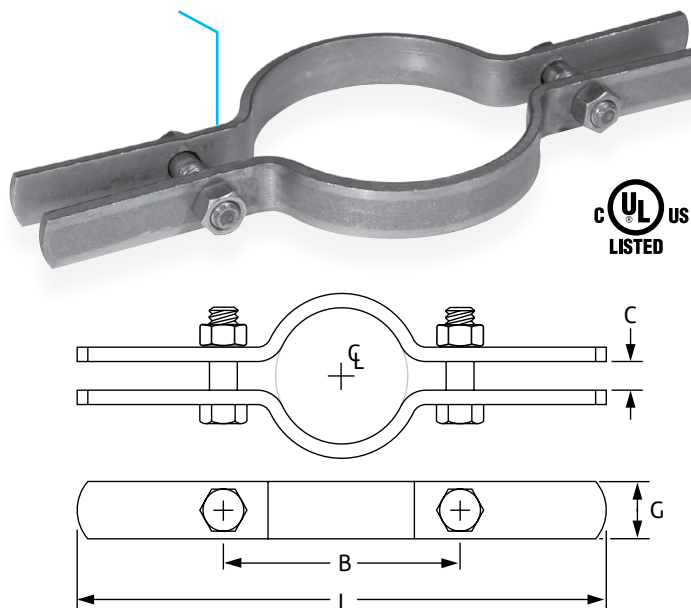

Size Range: ¾" through 24"

Material: Carbon steel

Finish: ☐ Plain, ☐ Hot-Dip Galvanized with Zinc Plated Bolts & Nuts, ☐ Epoxy Coated or ☐ Painted.

Service: For support of stationary steel pipe risers, cast iron pipe or conduit. This product is not intended for use with hanger rods. For this application refer to Fig. 40 Riser Clamp.

Maximum Temperature: Plain 650° F, Galvanized and Epoxy 450° F

Approvals: Complies with Federal Specification A-A-1192A (Type 8) WW-H-171-E (Type 8), ANSI/MSS SP-69 and MSS SP-58 (Type 8). UL, ULC Listed (Sizes 1½" – 8").

Installation: Clamp is fitted and bolted preferably below a coupling, hub or welded lugs on steel pipe. Bolt torques should be per industry standards (see page 248). Clamp is designed for standard steel pipe O.D. and this must be considered in sizing the riser for other types of piping.

Ordering: Specify pipe size, figure number, name and finish.



Note: Refer to Technical Data Section of the Pipe Hanger Catalog for cast iron soil pipe data.

Fig. 261: Dimensions (in) • Loads (lbs) • Torque (ft-lbs) • Weight (lbs)

Pipe Size	Max Load	Weight	L	G Width	B	C	Bolt Diameter	Torque Values
½ & ¾	220	1.1	8⅞	1	2⅞	⅜	⅜	21
1		1.1	3⅞					
1¼		1.6	3½					
1½	250	1.6	10⅞		3⅞	½	⅞	32
2		1.7	4¼					
2½		1.9	4¾					
3	500	1.9	11⅜		5½	½	½	46
3½	600	2.3	12⅞		6½			
4	750	2.4	13¾		7			
5	1,500	3.6	14¾	1½	8	⅝	⅝	100
6	1,600	4.0	18½		9			
8	2,500	7.6	20¼		12			
10		11.1	22¾	13¾	¾	¾	150	
12		16.5	24	15¾				
14	17.7	26	17¼					
16	2,900	30.4	28	2½	19¾	¾	¾	190
18		33.8	30		21¾			
20		35.0	36¾		23¾			
24	3,200	82.0	3	30	1	⅞		

PROJECT INFORMATION	APPROVAL STAMP
Project:	☐ Approved
Address:	☐ Approved as noted
Contractor:	☐ Not approved
Engineer:	Remarks:
Submittal Date:	
Notes 1:	
Notes 2:	

Riser Clamp – Standard Fig. 40

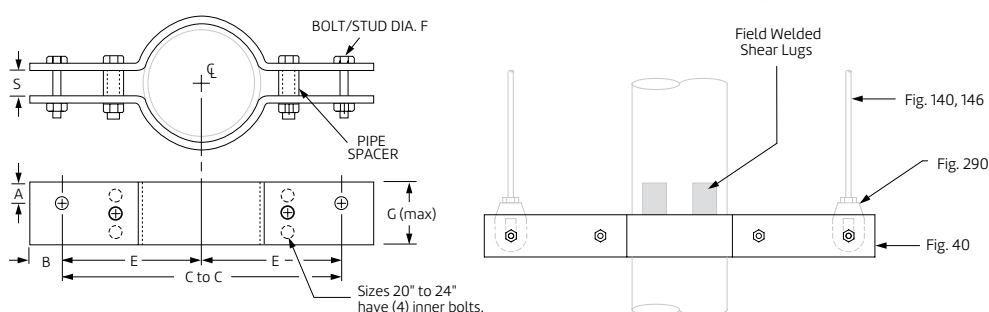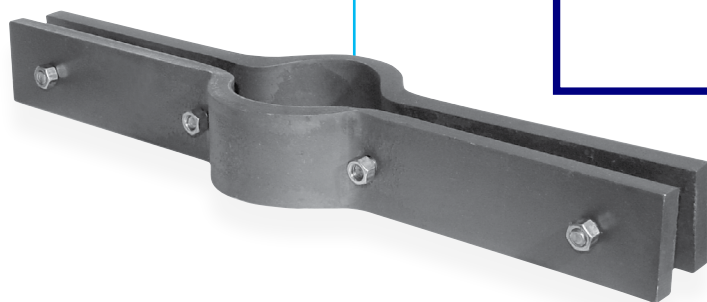

Size Range: 2" through 24"

Material: Carbon steel (CS), Alloy (A), or Stainless Steel (SS)

Finish: ☐ Plain or ☐ Hot-Dip Galvanized with Zinc Plated Fasteners

Maximum Temperature: Galvanized 450° F, 650° F (CS), 950° F (A) and 1,000° F (SS)

Service: Riser clamps are used for the support of vertical piping. Load is carried by shear lugs which are welded to the pipe. Shear lugs provided upon request. Local pipe wall stress evaluation available upon request.

Approvals: Complies with Federal Specification A-A-1192A (Type 42), ANSI/MSS SP-69 and MSS SP-58 (Type 42).

Ordering: Specify pipe size, material, figure number, name and finish.

Note: If different loads or dimensions are required, refer to Fig. 40 SD special design riser clamp.

Fig. 40: Dimensions (in) Loads (lbs) • Weight (lbs)

Pipe Size	Max Load		C-C	E	F (max)	G (max)	S	A (CS)	A (alloy) (SS)	B (max)	Maximum Weight Each		
	Rigid Assembly	Spring Assembly									CS	SS	Alloy
2	900	1,800	18	9	3/8	2½	3/4	1¼	7/8	2	18	15	18
2½			20	10				20			20	20	
3	1,500	3,000	20	10	1/2	3		1½	1/8		30	25	30
4	2,200	4,400	22	11		4		2			2	40	40
5	3,000	6,000	24	12	5/8		5	1	7/8		1¼	45	40
6			27	13½		60			60		73		
8	5,500	11,000	30	15	7/8	6	1½	1¼	1⅝	82	82	82	
10	7,800	15,600	32	16	1	7	1¾	1⅜	1⅞	2½	157	157	157
12			34	17				1⅞	1⅞		216	202	250
14	36	18	1/8	6				2	1½		2	228	228
16	9,000	18,000		39	19½	7	314		277		315		
18				42	21	2	7		338		338	377	
20	13,500	27,000	45	22½	2	10	2½	2⅝	2⅝		4¼	525	525
24			45	22½				11	2⅝	2⅝		621	565

PROJECT INFORMATION	APPROVAL STAMP
Project:	☐ Approved
Address:	☐ Approved as noted
Contractor:	☐ Not approved
Engineer:	Remarks:
Submittal Date:	
Notes 1:	
Notes 2:	